



-2/ QTY.	-3/QTY.	-4/QTY.	-6/QTY.	-8/QTY.	В/О	Part #	Description	Material	B/O INFORMATION OR SPECIFICATIONS	PG.
1	1	1	-	-		SWA6A-100	LOWER END	SS 17-4, H1075, H1150		1
-	-	-	1	-		SWA6A-110	LOWER END	SS 17-4, H1075/H1150		1
-	-	-	-	1		SWA6A-110A	LOWER END	S 17-4, H1075/H1150		
1	1	1	-	-		SWA6A-200	UPPER END	SS 17-4, H1150, H1075		1
-	-	-	1	-		SWA6A-210	UPPER END	SS 17-4, H1075/H1150		1
-	-	-	-	1		SWA6A-210A	UPPER END	SS 17-4, H1075/H1150		1
1	1	1	1	1		SWA6A-300	BEARING HOUSING	SS 17-4 H1150/H1075		1
1	1	1	1	1		SWA6A-400	THRUST WASHER	AL-BRONZE 630		1
1	1	1	1	1		SWA6A-500	SEMI - RING	17-4, H1150		1
1	1	1	1	1		SWA6A-600	COLLAR	17-4, H1150, H1075		1
2	-	-	-	-		SWA6A-700	WIRE CLAMP	6061-T6		1
-	-	2	2	-		SWA6A-700A	WIRE CLAMP	6061-T6		1
-	2	-	-	-		SWA6A-700B	WIRE CLAMP	6061-T6		1
-	-	-	-	2		SWA6A-700C	WIRE CLAMP	6061-T6		1
1	-	-	-	-		SWA6A-800A	CONNECTOR BUSHING			1
-	1	1	-	-	1	SWA6A-800B	CONNECTOR BUSHING			1
-	-	-	1	-		SWA6A-800C	CONNECTOR BUSHING			1
1	-	-	-	-	В/О	SWA6A-900A	ROTARY CONTACT		MERCOTAC #230	1
-	1	-	-	-	В/О	SWA6A-900B	ROTARY CONTACT		MERCOTAC #330	ī
-	-	1	-	-	В/О	SWA6A-900C	ROTARY CONTACT		MERCOTAC #430	1
-	-	-	1	-	B/O	SWA6A-900D	ROTARY CONTACT		MERCOTAC #630	
-	-	-	-	1	В/О	SWA6A-900E	ROTARY CONTACT		MERCOTAC #830	1
1	1	1	1	1	1	SWA6A-1100	UPPER DU BEARING			
1	1	1	1	1	В/О	SWA6A-1200	LOWER DU BEARING		(KAMAN #MB4520DU)	
1	1	1	1	1	B/O	SWA6A-1300	ROLLER THRUST BEARING		(KAMAN 81109TN)	$I_{I}I$
1	1	1	1	1	В/О	SWA6A-1400	CIRCLIP		(KAMAN #N13000 300SPP)	1
1	1	1	1	1	1	SWA6A-1800	COVER	S.S.		
4	6	4	8	12	В/О	SWA6A-1900	1/4" FEMALE SPADE CONNECTOR		(MCMASTER-CARR #69525K16)	1
-	-	4	4	4	В/О	SWA6A-2000	1/8" FEMALE SPADE CONNECTOR		(MCMASTER-CARR #69525K14)	1
4	4	4	4	12	В/О	188-FSCS-1032-5/8	FLAT SOCKET CAP SCREW	S.S.	10-32 x 5/8 (MCMASTER-CARR #92210A303)	1
1	-	-	-	-	В/О	188-FPSS-1032-5/8	SET SCREW	S.S.	10-32 x 5/8 (MCMASTER-CARR #92311A430)	1
1	-	-	-	-	B/O	TEXCAN#01121-724AM	2 CONDUCTOR 14 AWG		6 FT. (TEXCAN #01121-724AM)	N/S
	<u> </u>	-	-	-	+		3 CONDUCTOR 14 AWG		6 FT. (TEXCAN #01121-734A5 OR 01004-08-047)	N/S
-	-	1	-	-	B/O		4 CONDUCTOR 14 AWG		6 FT. (TEXCAN #01121-744A5)	N/S
-	-	-	1	-	B/O		6 CONDUCTOR 14 AWG		6FT. (TEXCAN #04121-764A5)	N/S
	-	-	-	1	+		8 CONDUCTOR 14 AWG		6FT. (TEXCAN#12701-08-014 OR McMaster#7081K38)	N/S
1	1	1	1	i i	B/O		UP DECAL A		G. 1. (12.07.101.12.01.00.014.01.700.110.01	N/S
<u> </u>	<u> </u>	1	<u> </u>	<u> </u>	B/O		SET SCREW	S.S.	10-32 X 1/2 (MCMASTER-CARR #94355A337)	1,4,5
	<u> </u>	-	1	-	B/O		SET SCREW	S.S.	10-32 X 3/8 (MCMASTER-CARR #94355A335)	$\vdash$
	<del></del>	_	<del></del>	1	B/O		SET SCREW	S.S.	10-32 X 1/4 (MCMASTER-CARR #94355A330)	H
1	1	-	-	<u> </u>	B/O		FEMALE PLUG		(MCMASTER-CARR #7216K6)	$\vdash$
<u> </u>	<u> </u>	_	<u> </u>	-	B/O		MALE PLUG		(MCMASTER-CARR #7216K5)	$\vdash$
	1	1	1	1	B/O		SLEEVE		7/8 OD X 1 (MCMASTER-CARR #6381K171)	H
1										


REV A B		REVISIONS								
	REV	ECR	DESCRIPTION	DATE	INITIAL	APPROVED				
	Α		REPLACED ID DECAL 600.1318 WITH LASER ETCH	11/16/2012	JAG					
	В		ADDED MISSING PART C45-15-13	8/8/2013	JAG	RW				
	3	15-0105	UPDATED TO NEW DRAFING STANDARDS. ADDED LASER ENGRAVING SHEET. \$WA6A-1900 CH'D GTY'S: ASSY -4 WAS 8 IS 4, ASSY -6 WAS 12 IS 8, ASSY -8 WAS 16 IS 12. \$WA6A-2000 ADDED P/N: ASSY -4, -6, -8 GTY 4. EL-PLUG-F. & EL-PLUG-M. CH'D GTY'S: ASSY -4, -6, -8 WAS 1 IS 0. 188-FPSS-1032-5/8 CH'D GTY'S: ASSY -3, -4, -6, -8 WAS 1 IS 0. 188-FPSS-1032-1/4 ADDED P/N: ASSY -8 GTY 1. 188-FPSS-1032-1/2 ADDED P/N: ASSY -8 GTY 1. 188-FPSS-1032-1/2 ADDED P/N: ASSY -4 GTY 1. 188-FPSS-1032-1/2 ADDED P/N: ASSY -4 GTY 1. EL314-SITOW, EL414-ARTIC, EL616-ARTIC, EL616-ARTIC, CH'D GTY'S: ASSY -2, -3, -4, -6, -8 WAS 6 IS 1. ADDED B/O INFO 6FT. 600.1319 ADDED CUSTOMER REBUILD ONLY NOTE. CH'D P/N WAS 188-FSCS-1032-1/2 IS 188-FSCS-1032-5/8 ADDED B/O INFO 6F72210A303.	5/15/2015	DPD	JAG				
	4	17-0114	CH'D P/N WAS <b>EL816-ARTIC</b> ARTIC IS <b>30806</b> & CH'D B/O INFO WAS 6FT. (TRUCK & AUTO SUPPLY #EL816-ARTIC) IS 6FT. (POLAR WIRE #30806). ADDED NOTE 3.	5/10/2017	RJC	SM				
	Е		WIRE CLAMP -700B ADDED FOR 3 WIRE CONFIG., WIRE P/N CHANGED, 2 WIRE ADDED, NOTES CHANGED, DART PLACARD ADDED	2/13/2019	VM	VM				
	F		ITEM INTO -8 WAS SWA6A-210 IS SWA6A-210A, ITEM INTO -8 WAS SWA6A-700A IS SWA6A-700C, QTY OF 188-FSCS-1032-5/8 INTO -8 WAS 6 IS 8	2019-08-29	VM	VM				
	G		ITEM INTO -8 WAS SWA6A-110 IS SWA6A-110A, QTY OF 188FSCS-1032-5/8 INTO -8 WAS 8 IS 12	2019-09-05	VM	VM				

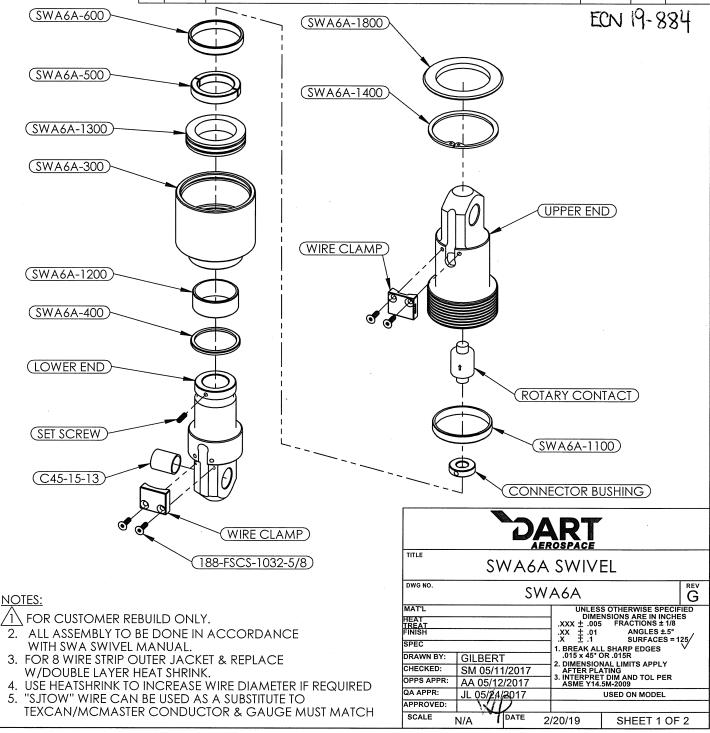



This drawing, specifications, and concepts contained here in are the sole property of Dart Aerospace, and may not be reproduced or used in any fashion without the prior written permission of Dart Aerospace Eugene, OR.

		REVISIONS			
REV	ECR	DESCRIPTION	DATE	INITIAL	APPROVED
3	15-0105	ADDED LASER ENGRAVING SHEET.	5/15/2015	DPD	SM

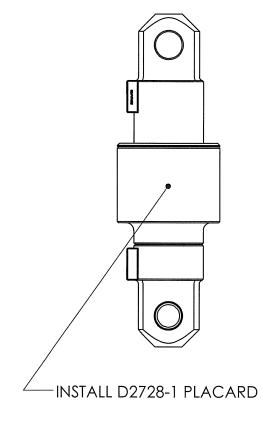

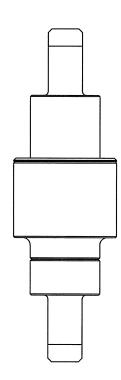

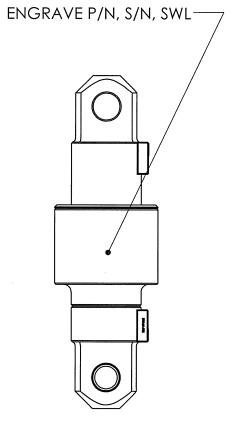

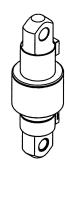

		AER	RT		
TITLE	SV	VA6A	SWIVI	ΞL	
DWG NO.		SW	A6A		G
//AT'L				S OTHERWISE SPECIF	
IEAT				NSIONS ARE IN INCHE FRACTIONS ± 1/8	ES
REAT INISH			.XX ± .01		,
SPEC					25/
RAWN BY:	GILBERT		.015 x 45° C		•
HECKED:	SM 05/1		2. DIMENSION AFTER PLA	NAL LIMITS APPLY	
PPS APPR:	AA 05/12			I DIM AND TOL PER	
QA APPR:	JL 05/2/4	2017		USED ON MODEL	
APPROVED:	M	)			
SCALE	N/A	DATE 2	/20/19	SHEET 2 OF	2
	N/A	2	/20/19	SHEET 2 OF	2